



Notice of Discontinuation

Company: KYCON, Inc.
305 Digital Dr.
Morgan Hill, CA 95037
USA
408-494-0330

2/2/2023

Re: **EOL**

Part Number: KLDX-0202-AHT; KLDX-0202-BHT

Please note that the above part numbers are EOL due to worn tooling.

Engineering has approved an alternate part.


Please contact your Kycon Sales Representatives for details.

Alternate part numbers:

KLDX-0202-AHT-1

KLDX-0202-BHT-1

Redline drawing attached

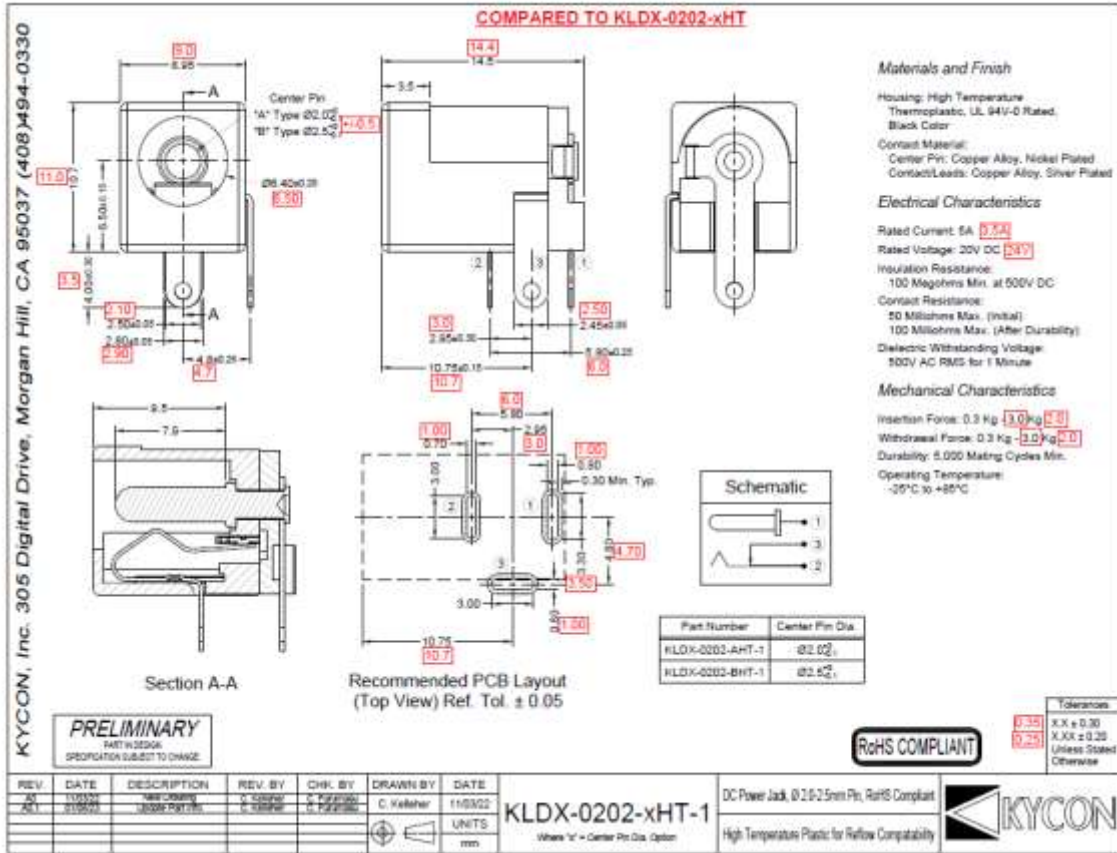

Please contact your Kycon sales representative if you require more information.

Signature: *Jill Scarnecchia*

Name: Jill Scarnecchia Phone: 408-494-0330