



Notice of Discontinuation

Company: KYCON, Inc.
305 Digital Dr.
Morgan Hill, CA 95037
USA
408-494-0330

3/6/2023

Re: **EOL**

Part Number: STX-3150-5N-577C; STX-3150-5N-701C

Please note that the above part numbers are EOL due to worn tooling.

Engineering has approved an alternate part.

Please contact your Kycon Sales Representatives for details.

Alternate part numbers:


STX-3150-5N-577C-1

STX-3150-5N-701C-1

Redline drawing attached

KYCON, Inc. 305 Digital Drive, Morgan Hill, CA 95037 (408)494-0330


Dimensions Differing From STX-3150-5N-xxx Rev. A2

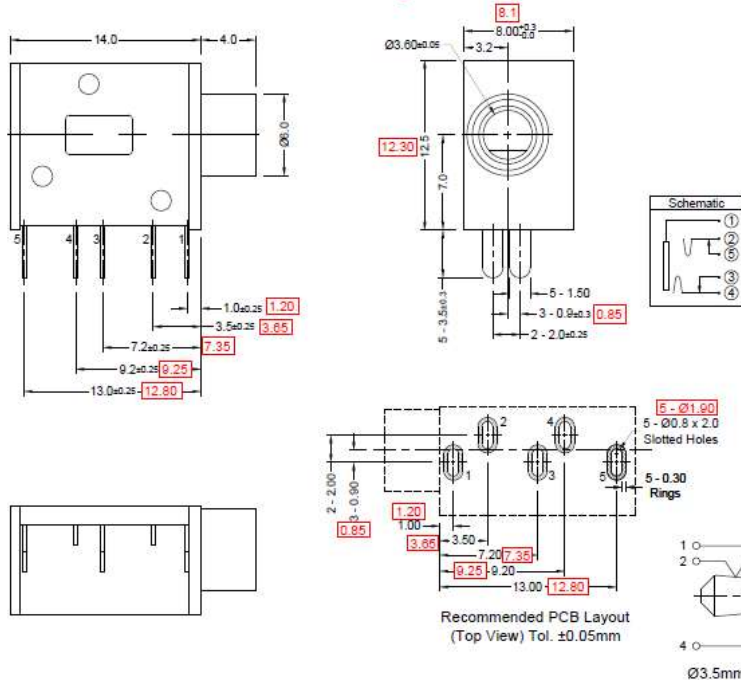

PRELIMINARY
PART IN DESIGN
SPECIFICATION SUBJECT TO CHANGE

REV.	DATE	DESCRIPTION	REV. BY	CHK. BY	DRAWN BY	DATE	UNITS
AD	12/02/22	New Drawing	C. Kelleher	G. Furumasa	C. Kelleher	11/21/22	mm
AE	02/17/23	Update Dim's & Pin-Code	C. Kelleher	C. Furumasa			

Please contact your Kycon sales representative if you require more information.

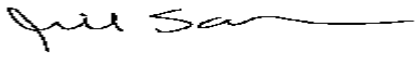Signature: 
 Name: Jill Scarnecchia Phone: 408-494-0330