



## **Notice of Discontinuation**

**Company:** KYCON, Inc.  
305 Digital Dr.  
Morgan Hill, CA 95037  
USA  
408-494-0330

**9/27/22**


Re: **EOL**

**Part Number: KMDMIX-NS3B-WS-BTR**

Please note that the above part number is EOL. Unfortunately, we have no stock and cannot offer a last time buy.

We will continue to offer the KMDMIX-NS3A-WS-BTR, which is a more popular part. Please see the attached redline.

KYCON, Inc. 305 Digital Drive, Morgan Hill, CA 95037 (408)494-0330

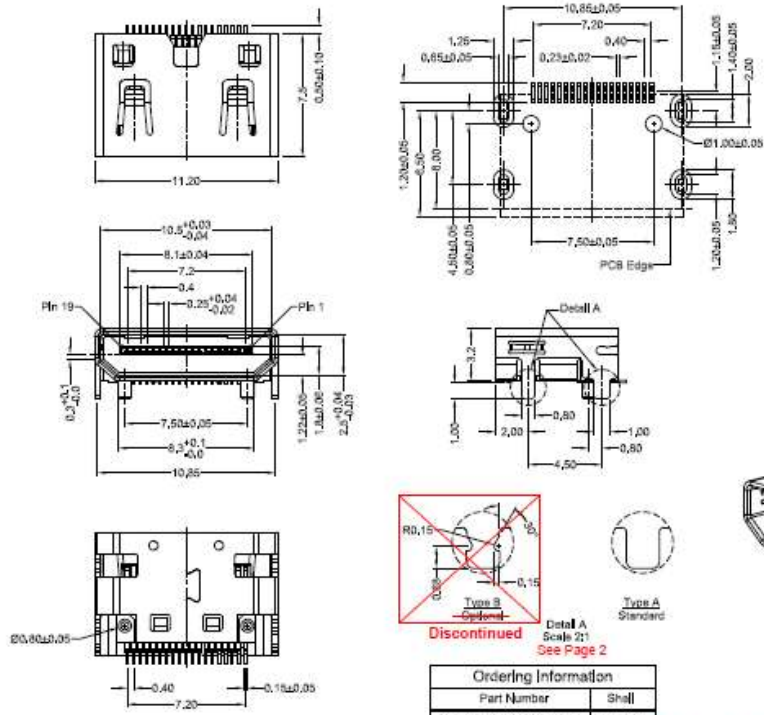

**Material and Finish**  
Housing: High Temp. Thermoplastic, UL94V-0 Rated, color-Black  
Contacts: Phosphor Bronze  
SHM: Nickel plated  
Plating Option: Standard - 30u" Gold In front contacts and Gold Flash In Solder area

**Electrical Characteristics**  
Insulation Resistance: 100 Mohm min.  
Dielectric Withstanding Voltage: 500V AC RMS for 1 minute  
Operating Rating: 0.5A Max.  
Operating Temperature: -25°C to +85°C  
Durability: 5000 Mating Cycles Min.

Ordering Information	
Part Number	Shell
KMDMIX-NS3A-WS-BTR	Type A
<del>KMDMIX-NS3B-WS-BTR</del>	<del>Type B</del>

**Discontinued**



Tolerances
XX ± 0.25
X,XX ± 0.15
Unless Stated Otherwise

REV.	DATE	DESCRIPTION	REV. BY	CHK. BY	DRAWN BY	DATE
20	04/26/07	New Product	A. Friedrick	R. Ma	A. Friedrick	04/22/07
21	05/16/07	Reference Change	W. Sosa	W. Sosa	P. M. Lopez	
22	07/25/13	SKU Update	W. Sosa	W. Sosa	A. Shaban	
23	08/27/13	Address Update	W. Sosa	W. Sosa	A. Shaban	

KMDMIX-NS3x-WS-BTR	UNITS: mm
--------------------	-----------

HDMI(TM) Mini Connector, Right Angle SMT.  
No flange, top spring, TH Shield, RoHS Compliant



Please contact your Kycon sales representative if you require more information.

Signature:   
Name: Jill Scarnecchia Phone: 408-494-0330